



CURVE	RADIUS	ARC LENGTH	CHORD LENGTH	CHORD BEARING	DELTA ANGLE	TANGENT
C1	50.00'	43.21'	41.88'	S 43°29'41" W	49°30'48"	23.06'

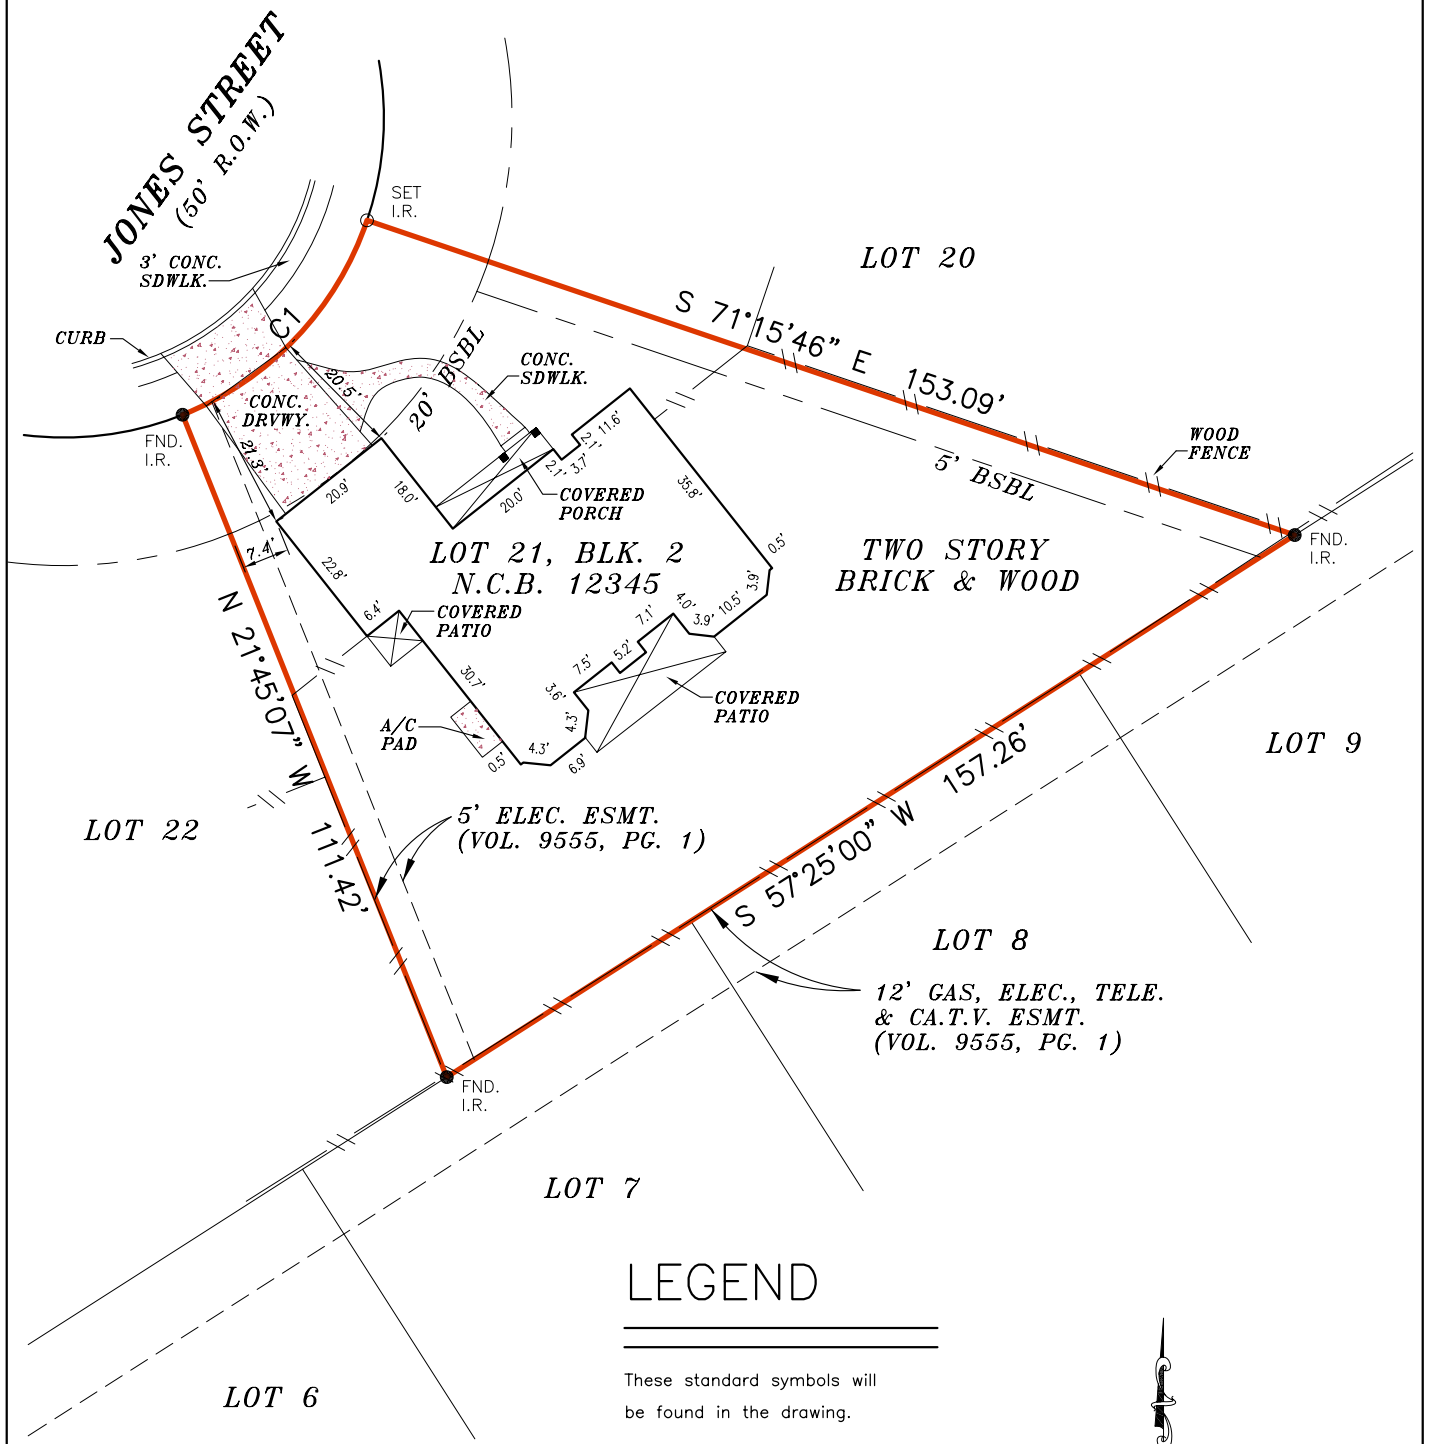

LEGEND

These standard symbols will be found in the drawing.

- BOUNDARY LINE
- EASEMENT LINE
- BUILDING SETBACK LINE
- WOOD FENCE
- SET IRON ROD
- FOUND IRON ROD

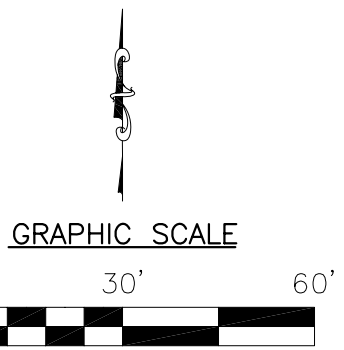

FLOOD INSURANCE NOTE: By graphics plotting only, this property is in ZONE A of the Flood Insurance Rate Map, Community Panel No. 48029C 0254 F, effective date of January 4, 2002. Exact designations can only be determined by a Elevation Certificate. Based on the above information, this property IS NOT in a Special Flood Hazard Area.

I, ARMANDO A. ARANDA, a Registered Professional Land Surveyor in the State of Texas, do hereby certify to ABC TITLE COMPANY and ANY BANK USA that the above map is true and correct according to an actual field survey, made by me or under my supervision, of the property shown hereon or described by field notes accompanying this drawing. I further certify that all easements and rights-of-way of which I have been advised are shown hereon and that, except as shown, there are no visible encroachments, no visible overlapping of improvements and no apparent discrepancies or conflicts in the boundary lines, and no visible physical evidence of easements or rights-of-way as of the date of the field survey. I further certify that this survey meets or exceeds the minimum standards established by the Texas Board of Professional Land Surveying (Section 663.18).
 Lot(s) 21, Block 2, N.C.B. 12345, Survey No. _____, Abstract No. _____.
 Survey or Subdivision: JOE'S SUBDIVISION
 Volume 9555, Page 1, of the Deed and Plat Records of BEXAR County, Texas.
 Owner: JOE SOMEBODY
 Address: 123 JONES STREET GF No. 123456

FINAL "AS-BUILT" SURVEY				
JOB NO.:	08-0001	NO.	REVISION	DATE
DATE:	8/1/08			
DRAWN BY:	MKW			
APPROVED BY:	AAA			

SUBJECT TO RESTRICTIVE COVENANTS AND/OR EASEMENTS RECORDED IN: VOL. 7853, PG. 841, DEED RECORDS, BEXAR COUNTY, TEXAS VOL. 6674, PG. 1902, REAL PROPERTY, BEXAR COUNTY, TEXAS

HOUSE PICTURE:



ARMANDO A. ARANDA, R.P.L.S.
 Registered Professional Land Surveyor
 Registration No. 1398

AmeriSurveyors LLC
 809 Elizabeth San Antonio, Texas 78209
 Phone: (210) 367-2200 Fax: (210) 320-1043

SAMPLE